

N



LAND TYPE MAP For Lands Of David Keith Wilson Tracts #1A, #1B & #2


January 8, 2022
Saluda County, South Carolina

~~TRACT #1A~~

TYPE #	TYPE	ACRES	AGE/EST
1	Natura Pine/Hardwood	3.45	35+
2	Highway R/W	0.39	-
Total		3.84	-

~~TRACT #1B~~

TYPE #	TYPE	ACRES	AGE/EST
1	Natura Pine/Hardwood	6.53	+/-25
2	Highway R/W	1.38	-
Total		7.91	-

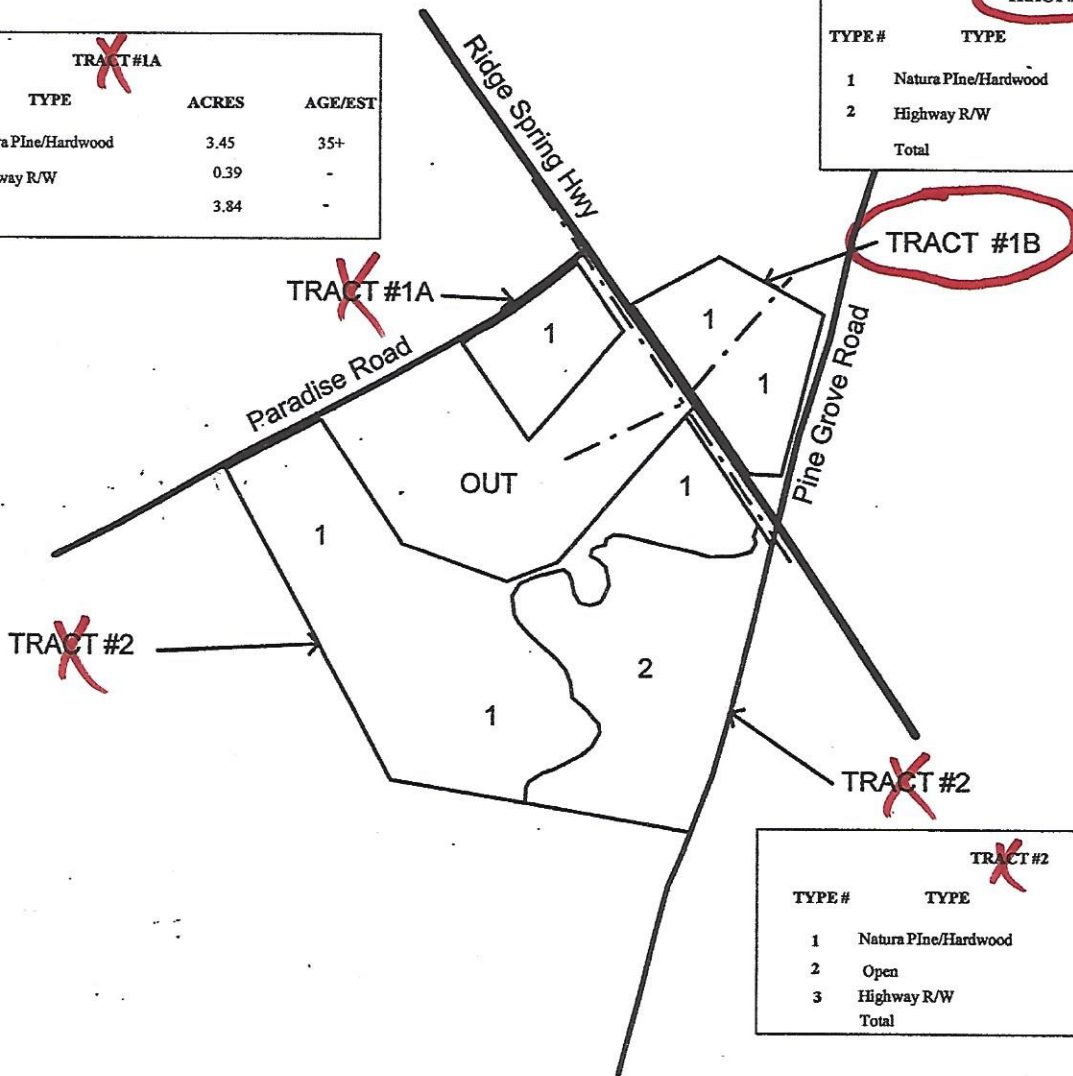

~~TRACT #2~~


TYPE #	TYPE	ACRES	AGE/EST
1	Natura Pine/Hardwood	22.3	+/-25
2	Open	13.0	-
3	Highway R/W	0.72	-
Total		36.02	-

LEGEND

- Property/Type Line
- Primary Paved Road
- Secondary Paved Road
- County Road
- Structure
- 1, 2, etc. Type #

File Name: Deese#12021

SCALE

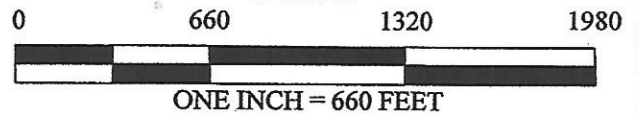

Drawn By:
JOHN C. WILSON
WILSON FORESTRY & APPRAISAL, INC
5732 Maybinton Road
Whitmire, SC 29178